




SECTION A-A

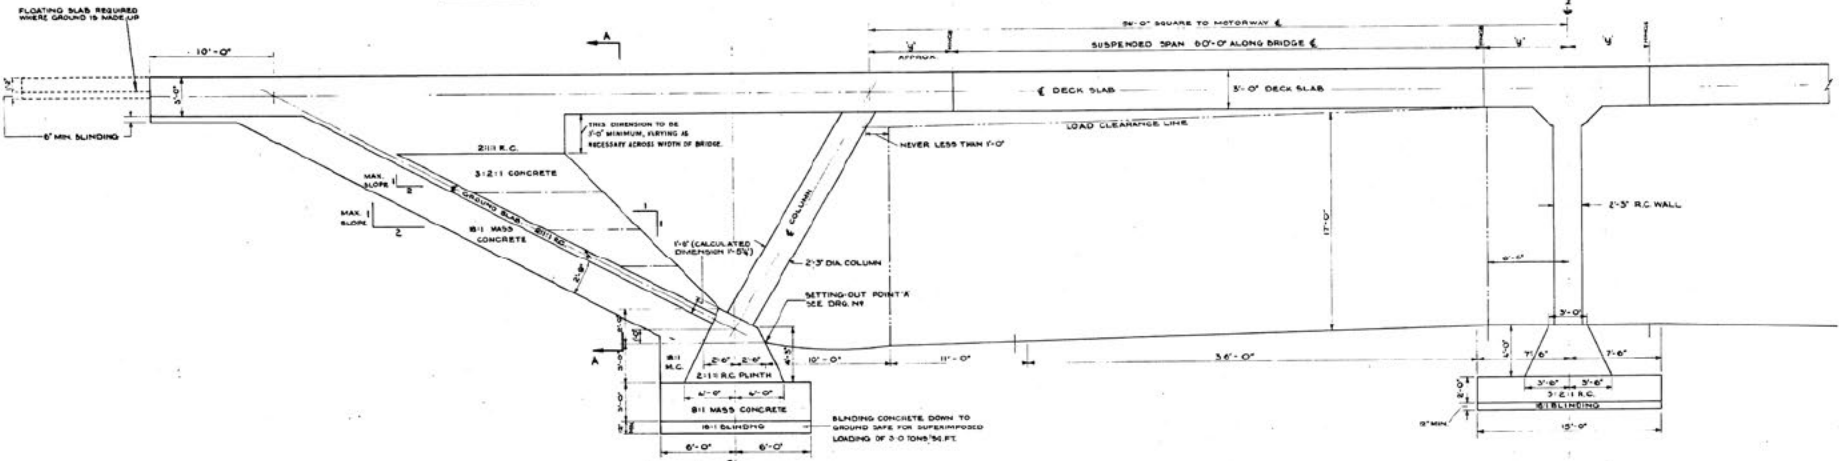

TYPICAL SECTION SQUARE TO MOTORWAY  
SCALE: 1/4 IN. TO 1 FT.

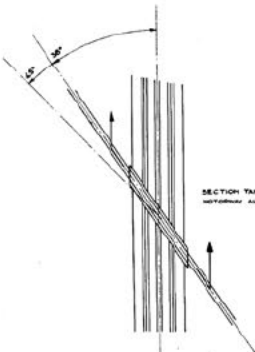

KEY PLAN  
SCALE: 1/2500

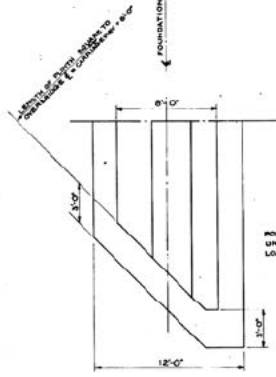

PART PLAN SHOWING END OF PLINTH AND FOUNDATION  
WITH GROUND SLAB REMOVED  
SCALE: 1/4 IN. TO 1 FT.

AS CONSTRUCTED DRAWING	
DATE	APPROVED
BY	BY
FOR	FOR

CONTRACT 41/66/1

OVERBRIDGES. SECTION SHOWING CONSTRUCTION DETAILS  
FOR ANGLES OF INTERSECTION NOT GREATER THAN 45° BUT OVER 36°

SCALES: 1/4 IN. TO 1 FT. & 1/2500



MINISTRY OF TRANSPORT  
LONDON-YORKSHIRE MOTORWAY  
CRICK-DONCASTER BY-PASS SPECIAL ROAD

APPROVED	DATE	APPROVED	DATE

SIR OWEN WILLIAMS AND PARTNERS,  
LONDON, W.1.

DRG. No. 784-3-18/2