


BRIDGE CARRYING SIDE ROAD OVER MOTORWAY WITH NO SOFFIT DEEPENING.

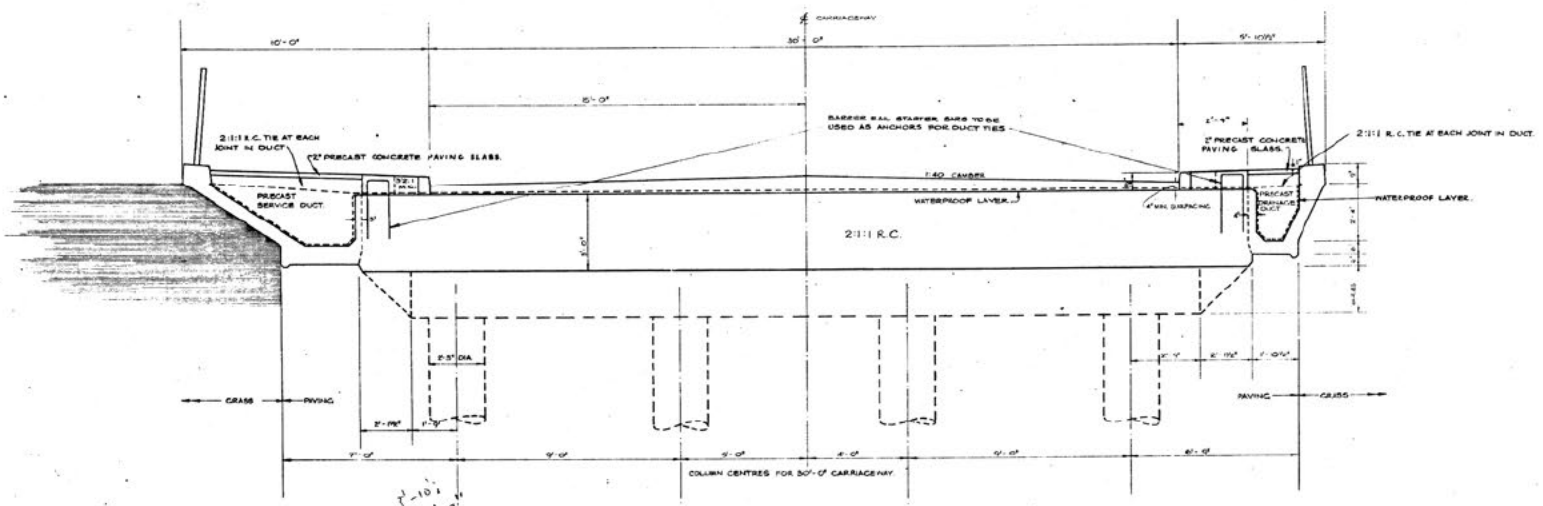

BRIDGE CARRYING ROUNDABOUT OVER MOTORWAY WITH SOFFIT DEEPENING OVER SUPPORTS.

3-10 1/2
 72 7-9 1/2
 27-1 1/2
 38-9 1/2 depth

AS CONSTRUCTED DRAWING
2-1-64 AND AMENDMENTS

CONTRACT 14/CE47

CROSS SECTIONS THROUGH STANDARD ROAD OVERBRIDGES.

SCALE - 1/2 INCH TO 1 FOOT.



CONTRACT	AMENDMENT	BY	DATE
14/CE47	1	A.B.C.	

MINISTRY OF TRANSPORT
LONDON-YORKSHIRE MOTORWAY
 CRICK (NORTHAMPTONSHIRE) - DONCASTER BY PASS SPECIAL ROAD

AMENDMENT	DATE	AMENDMENT
B-1-62		
A		BARRIER RAIL ADDED
B		BARRIER RAIL AMENDED
C		BARRIER RAIL CANCELLED
D		DUCT TIES INDICATED
E		1/2" CONCRETE & WATERPROOF LAYER INDICATED
F		UPSTAKE AT RAILING AMENDED TO 1"
G		LOW CONCRETE DELETED
H		UPSTAKE AT RAILING ON DRAINAGE DUCT AMENDED TO 1"
I		1/2" (1/4" CONCRETE IN TIE) AMENDED TO 2:1:1

SIR OWEN WILLIAMS AND PARTNERS
 LONDON N.W. MARCH 1962.
 D.R.C. No. 784-3-22/Z